

D

C

B


A

D

C

B

A

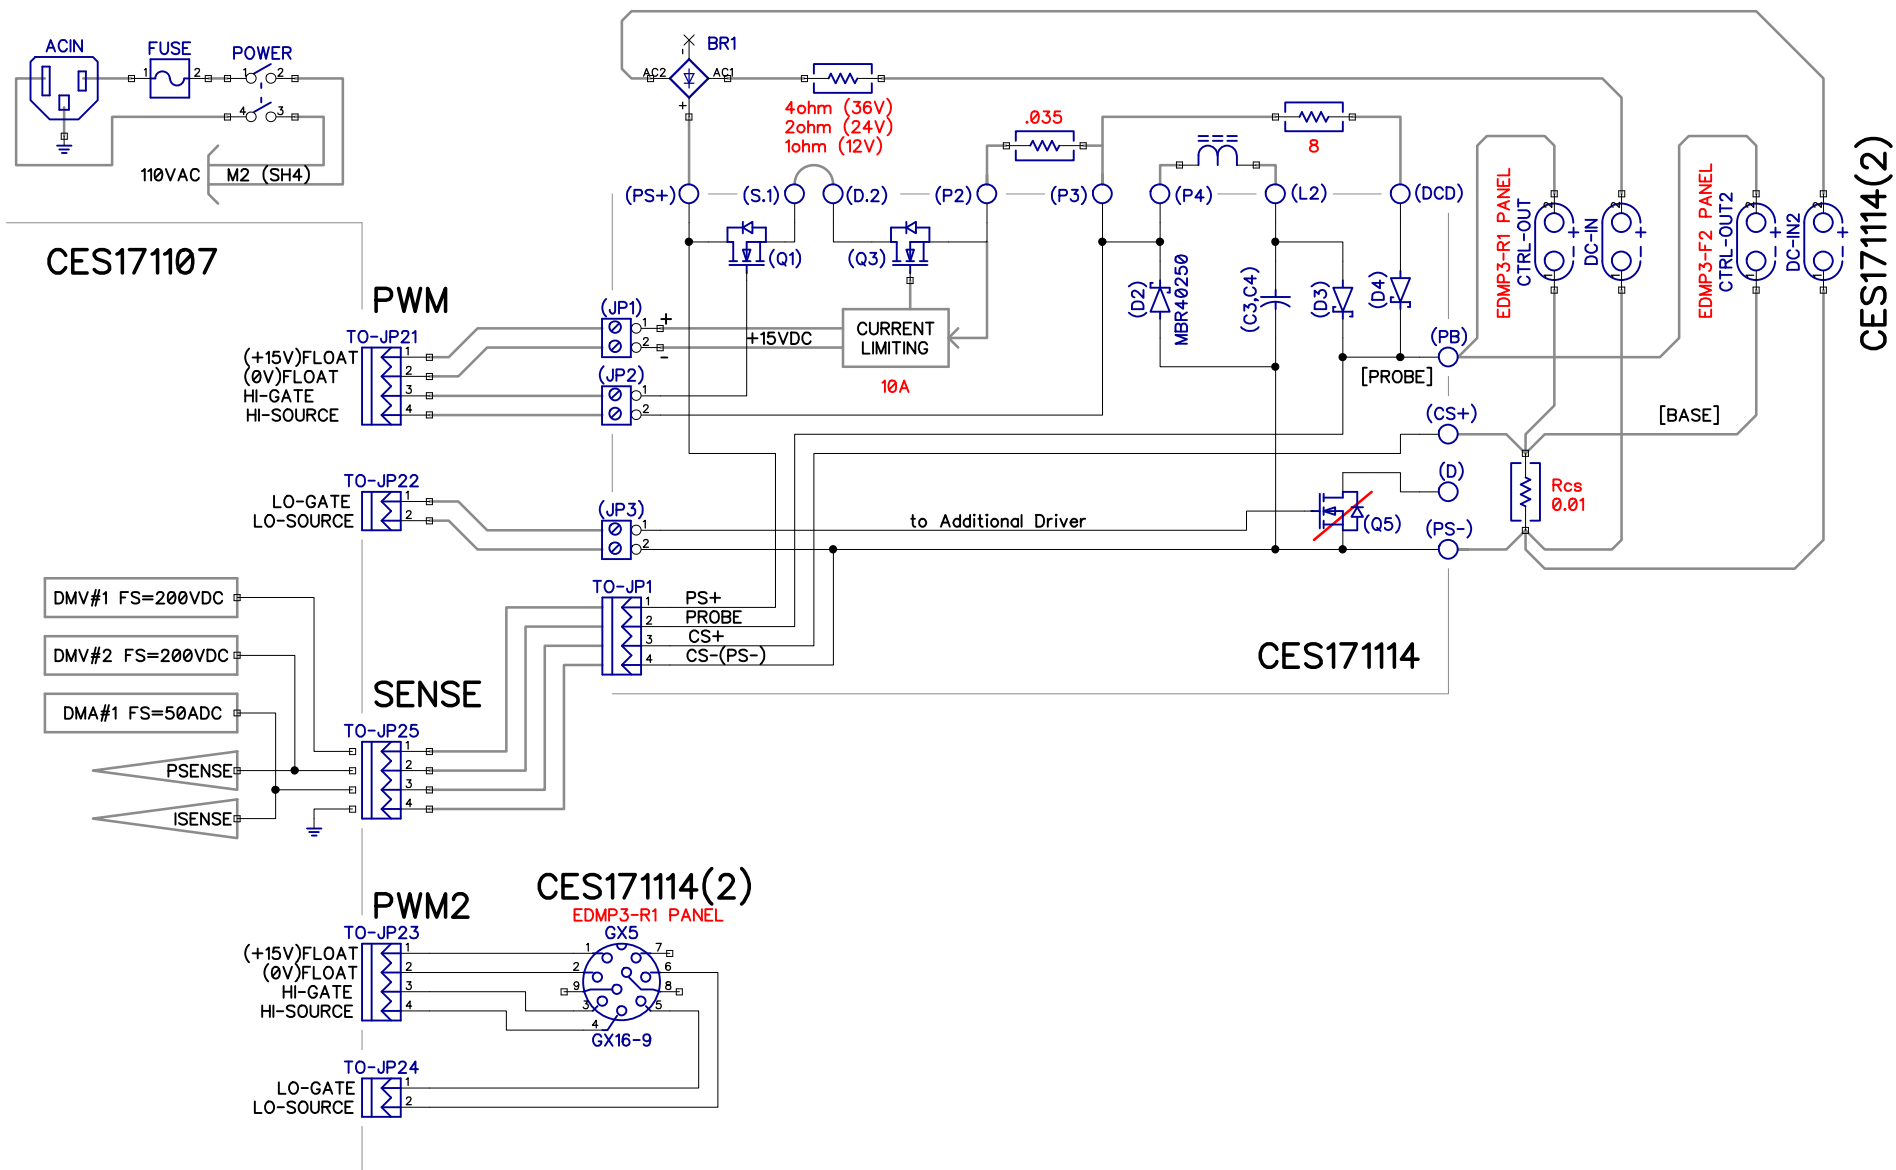

EDMP3 v01 as built
CES171114 CONFIG CKT


PROPRIETARY NOTICE

THIS DOCUMENT CONTAINS
PROPRIETARY INFORMATION
EXCLUSIVE TO C.E.S., AND SHALL
NOT BE REPRODUCED, USED, OR
DISCLOSED IN WHOLE OR IN PART
TO OTHERS EXCEPT AS
AUTHORIZED IN WRITING BY C.E.S..

C. E. S. WEST COVINA, CALIFORNIA, U.S.A.

DRIVER SCHEMATICS

SIZE	DWG NO.	REV
A	EDMDRV3	01a
EDMDRV3_v01-Mod1.dch		Sheet 2 of x

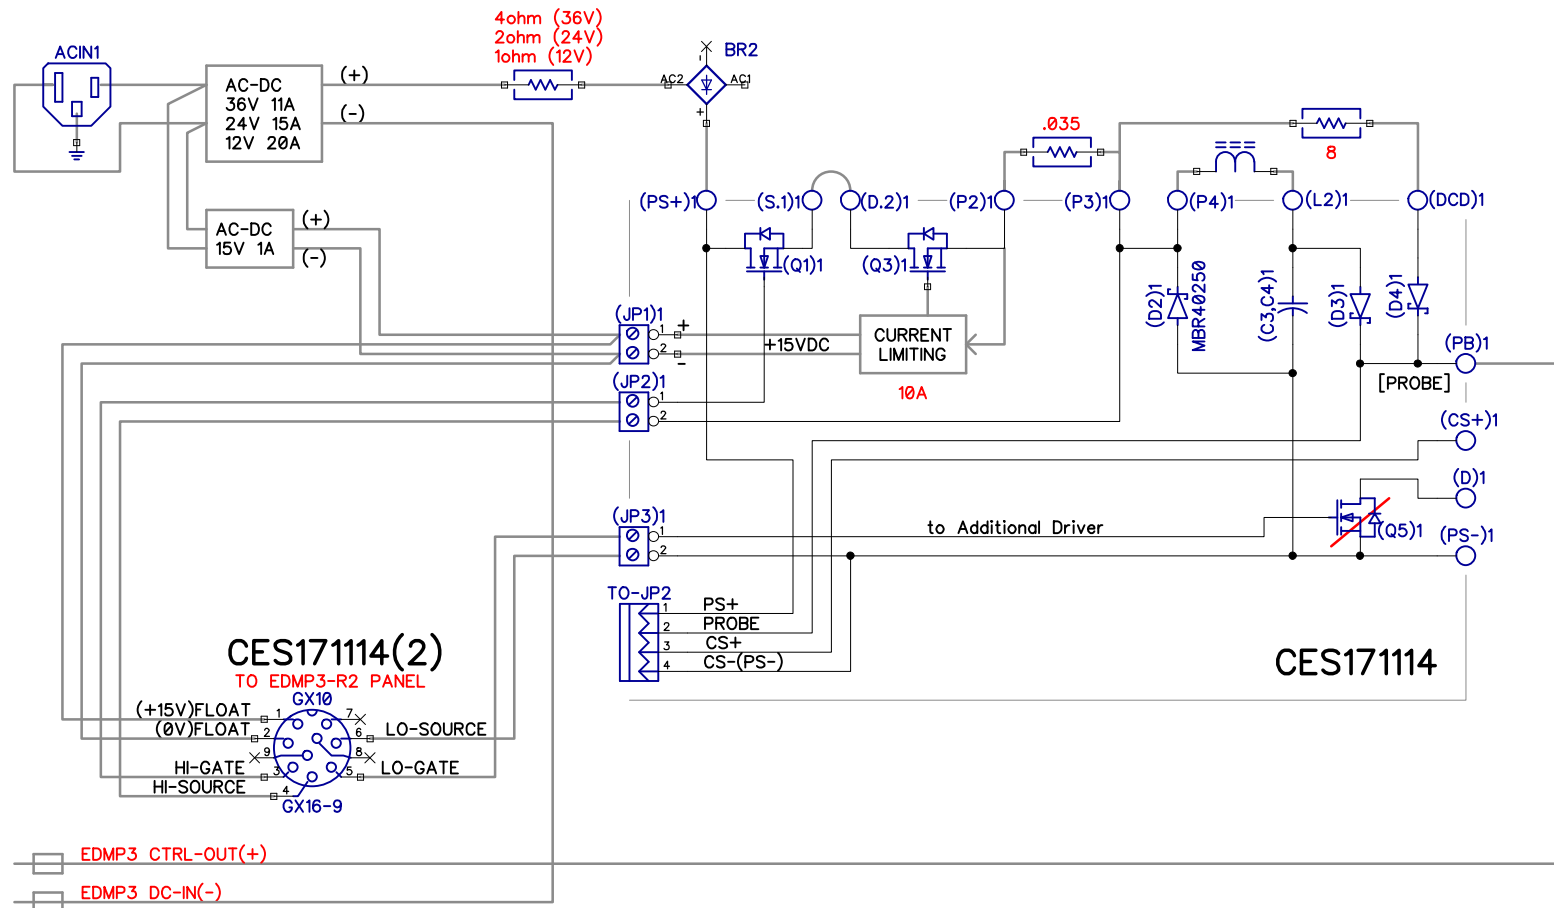

CES171114 EXTERNAL ADDIN CONFIG CKT

EDMP3 External Add-in
CES171114 CONFIG CKT

PROPRIETARY NOTICE

THIS DOCUMENT CONTAINS
PROPRIETARY INFORMATION
EXCLUSIVE TO C.E.S., AND SHALL
NOT BE REPRODUCED, USED, OR
DISCLOSED IN WHOLE OR IN PART
TO OTHERS EXCEPT AS
AUTHORIZED IN WRITING BY C.E.S..

C. E. S. WEST COVINA, CALIFORNIA, U.S.A.

DRIVER SCHEMATICS

SIZE	DWG NO.	REV
A	EDMDRV3	01a
EDMDRV3_v01-Mod1.dch		Sheet 3 of x